



Mark details

Nine figure	348900060	Mark name	SKIPTON PM 6
Status	OK	Alternate names	C470-5
Last used by		Stamped ID	
Date last used		Map	752213
Beacon			
Type	SCN (GDA), SCN (AHD)Permanent Mark		
Plan numbers			
Marker Post Exists		Cover Exists	
Mark Type		GNSS Suitability	
Ground to Mark			
Offset			
Comments			

Coordinates

Projection (MGA94)		Datum (GDA94)	
Easting	708000.325	Latitude	-37° 41' 05.7517"
Northing	5826523.281	Longitude	143° 21' 31.9296"
Zone	54	Ellipsoid height	292.779
Uncertainty	0.018	Order	3
Published date	26/09/2016	Technique	ADJUSTMENT
Source	OSGV	Measurements	DHLM

AHD

Height	289.534	Technique	SPIRIT LEVELLING
Uncertainty	0.012	Order	3
Published date	14/07/2014	Level section	SKI
Source	OSGV		

Point scale factor

PSF	1.0001329	Height	0.9999546	Combined	1.0000875
------------	-----------	---------------	-----------	-----------------	-----------

Nine figure	348900060	Status	OK	Type	SCN (GDA), SCN (AHD)
Easting	708000.325	Northing	5826523.281	AHD height	289.534
Latitude	-37° 41' 05.7517"	Longitude	143° 21' 31.9296"	Ellipsoid height	292.779
Hz uncertainty	0.018	Hz order	3	Vt uncertainty	0.012
Datum	GDA94	Plan ref		Vt order	3

SEC. 6 (1) (c) SURVEY CO-ORDINATION ACT 1958

PERMANENT MARK SKETCH PLAN

Township Skipton Parish Skipton

NOTE:—


Not necessarily to Scale

(1) Measurements to be shown from the Permanent Mark to as many near-by survey marks, buildings, fence posts, hydrants, trees, etc., as practicable. Up to six such measurements are desirable.

(2) Except where verified by a Licensed Surveyor in this survey, all boundaries in this sketch plan are to be shown by broken lines. The symbols for fences, buildings, etc., to be shown on the broken lines.

(3) Description of Permanent Mark and, where possible, Crown Abutments are to be shown.

MEASUREMENTS ARE IN metres

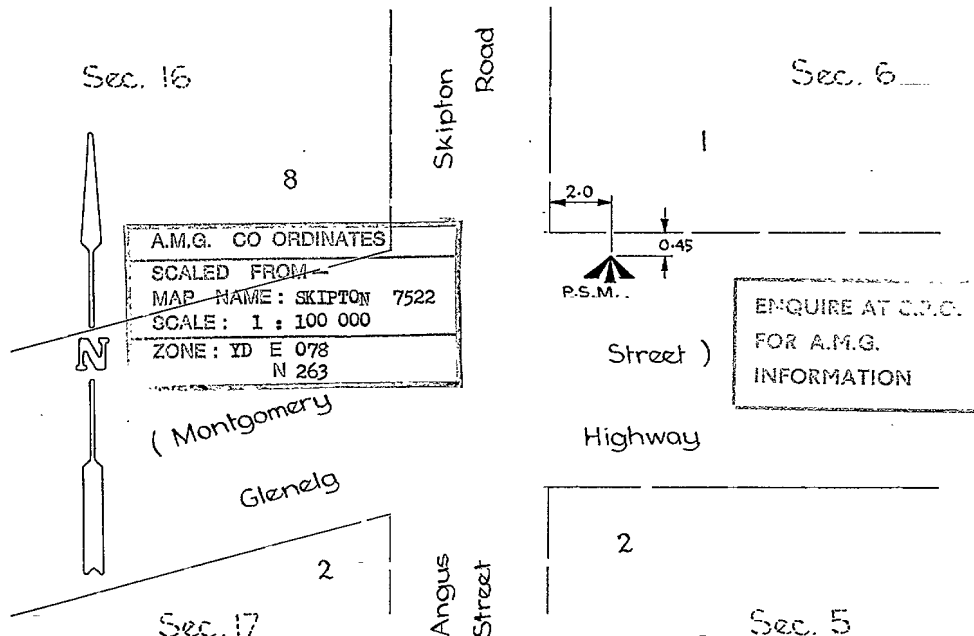

Established in connection with * Road Survey Ref. No. 31/77

IF LEVELLED:—

Reduced level of Mark to Datum †
†e.g., Railways, Board of Works, Sewerage Authority, etc., or Arbitrary

I certify that the Permanent Marks shown in this sketch have been established on the ground by me in accordance with the Regulations under the Survey Co-ordination Act 1958 and that the information shown hereon is correct.

Department or Authority Shire of Hampden Signature [Signature] †
Date 21.6.79

†If a Licensed Surveyor the Letters L.S. to be added

TO BE FILLED IN BY THE CENTRAL PLAN OFFICE

Zone	Square	Subdivision	Same Datum R.L.	Number
			R.L. Copied from	6

Noted on Record Plan S-289 (3) 5/10/79 [Signature]

T.O. Shire of Hampden S.R. & W.S.C. C.R.B.

25 JUN 1979